

This structure is exempt from inspection, however:

The California Building Code states: "Exemption from the permit requirements of this code shall not be deemed to grant authorization for any work to be done in any manner in violation of the provisions of this code or any other laws or ordinances of this jurisdiction."


The SRA Fire Safe Regulations: "The emergency access to, and perimeter wildland fire protection of, the inspection exempt structure must adhere to the California Board of Forestry safety measures, Title 14 Natural Resources."

APPROVED BY
EL DORADO COUNTY
PLANNING DEPARTMENT
Date: 12/5/12
By: Donna L. Lugo
Confidential: RA40

MIN. SETBACKS	
FRONT-	50'
RT SIDE-	50'
LT SIDE-	50'
REAR-	50'



PLOT PLAN
 OWNER: PETER NOBLEMAN
 NO. 806 1400 BRIZLEY PLATE CA.
 280 EITE AVENUE SCARBOROUGH, N.B. 12th FL. 10th
 PARCEL NO. 41-001-08
 SCALE 1" = 20'
 LOT AREA 5 AC.
 ZONING RESIDENTIAL
 DATE AUG 14 / 1994
 Page 5 of 5

El Dorado County
 Building Department
 SITE/GRADING PLAN REVIEW
 Engineer _____
 Bldg. Permit 21166
 Encroachment _____
 Grading _____

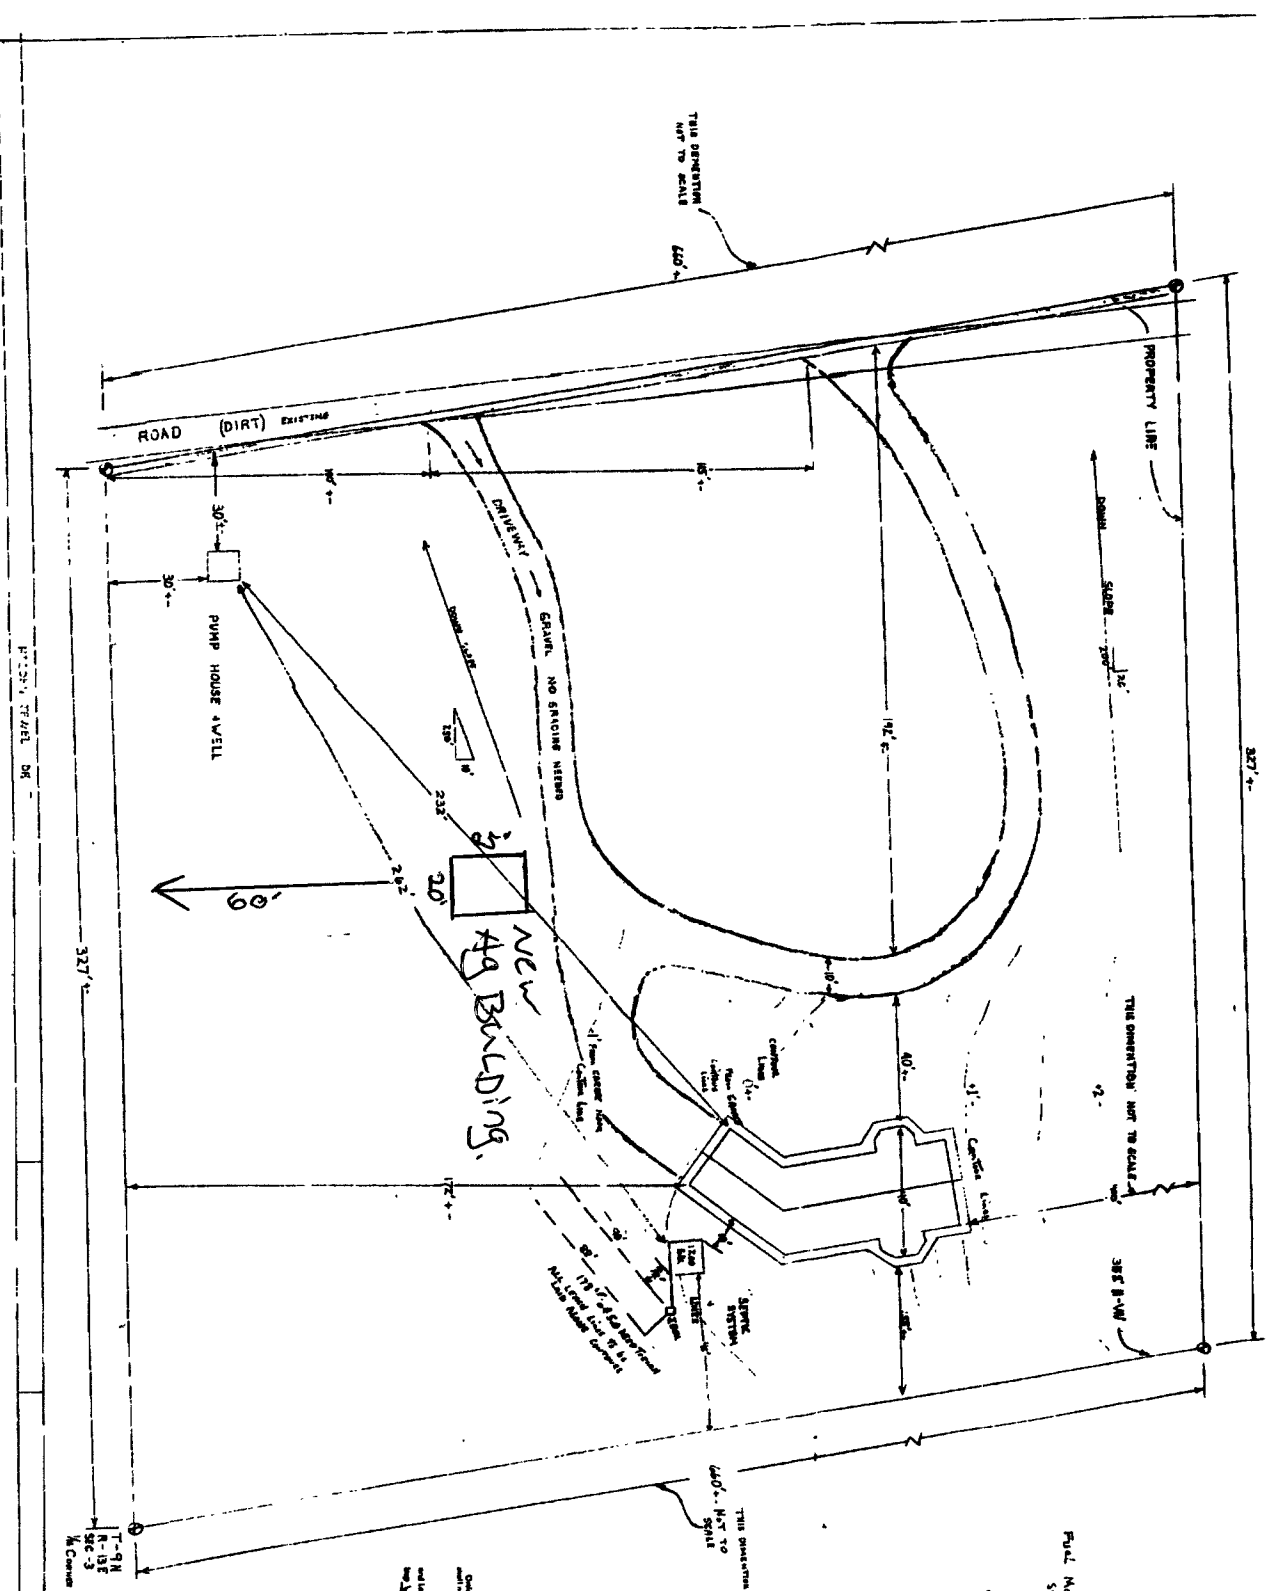

Fuel Modification shall comply with
Street Alter Safety Regulations
No Closing of all works that
Can move around all device
way. Roads is Engineering

4245 Sciaroni Rd
691-621-08-1

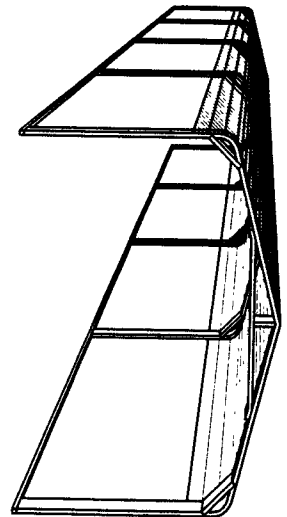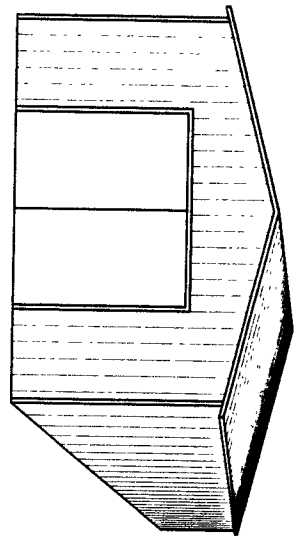

RYAN RODRIGUEZ
 4245 SCIARONI RD.
 GRIZZLY FLATS, CA 95635
 20' X 26' X 8'

DESIGN NOTES

1. ALL CONSTRUCTION SHALL BE PROVIDED IN ACCORDANCE WITH IBC 2009, OSHA, AISC, ASCE7-05, AWS D 1.1 CODES AND ALL APPLICABLE LOCAL REQUIREMENTS.
2. BASE CONNECTIONS SHALL BE PROVIDED AS SHOWN ON FOUNDATION DETAILS SHEET
3. ALL MATERIALS IDENTIFIED BY MANUFACTURER NAME MAY BE SUBSTITUTED WITH MATERIAL EQUAL OR EXCEEDING ORIGINAL.
4. ALL SHOP CONNECTIONS SHALL BE WELDED CONNECTIONS
5. ALL FIELD CONNECTIONS SHALL BE TKS #12 (1/4"x1")
6. STEEL SHEATHING SHALL BE 29GA CORRUGATED GALV. OR PAINTED STEEL - MAIN RIB HT. 5/4" (FY-BOKS) OR EQ.
7. ALL STRUCTURAL LIGHT GAUGE TUBING AND CHANNELS SHALL BE GRADE 50 STEEL.
8. STRUCTURAL TUBE T52 1/4"x2 1/4" - 14GA. IS EQUIVALENT TO T52 1/4"x2 1/4" - 12GA.
9. STRUCTURAL TUBE T52 1/4"x2 1/4" - 12GA. SHOULD BE ACCEPTED IN LIEU OF T52 1/4"x2 1/4" - 14GA. FOR IT IS A BETTER STRUCTURAL TUBING.

DESIGN CRITERIA

PREVAILING CODE: CBC 2010 (IBC 2009)
 USE GROUP: U (CARPORTS, BARNIS)

- | | |
|--|-------------------------|
| 1. DEAD LOAD (D) | D = 2.0 PSF |
| 2. ROOF LIVE / SNOW LOAD (L _r) | L _r = 70 PSF |
| 3. SNOW LOAD (S) | |
| GROUND SNOW LOAD | P _g = 70 PSF |
| IMPORTANCE FACTOR | I _s = 0.80 |
| 4. WIND LOAD (W) | |
| BASIC WIND SPEED | V _s = 90 MPH |
| EXPOSURE | C |
| IMPORTANCE FACTOR | I _w = 0.87 |
| 5. SEISMIC LOAD (E) | |
| SD _s / SD ₁ | 0.443 / 0.262 |
| DESIGN CATEGORY | D |
| IMPORTANCE FACTOR | I _e = 1.00 |
- LOAD COMBINATIONS:**
1. D + (L_r OR S)
 2. D + (W OR ±0.7E)
 3. D + 0.7S (W OR ±0.7E) + 0.7S (L_r OR S)
 4. 0.6D + (W OR ±0.7E)

DRAWING INDEX

1. COVER SHEET
2. ELEVATIONS
3. FLOOR PLAN & ANCHORS
4. FRAME SECTION & DETAILS
5. SIDE WALL FRAMING & DETAILS
6. END WALL FRAMING & DETAILS
7. FOUNDATION DETAILS

APPROVED

Omissions & Errors on Plans
 shall not be valid and all codes

DEC 05 2012

and Plans must be compiled with

Permit # 211664

THE INFORMATION CONTAINED IN THESE DRAWINGS IS THE SOLE PROPERTY OF INTERSTATE CARPORTS, INC. ANY REPRODUCTION IN PART OR WHOLE WITHOUT THE WRITTEN PERMISSION OF INTERSTATE CARPORTS, INC. IS PROHIBITED



THESE DRAWINGS HAVE BEEN PRODUCED USING A & A SOFTWARE DEVELOPMENT'S MB DESIGN SOFTWARE. THE DESIGNS SHOWN IN THESE DRAWINGS NEED TO BE VERIFIED AND SEALED BY A LICENSED PROFESSIONAL ENGINEER TO BE VALID. A & A SOFTWARE DEVELOPMENT AND ITS AFFILIATES ASSUMES NO LIABILITY FOR DRAWINGS NOT SEALED BY THEIR ENGINEERS. FOR INFORMATION REGARDING THE SOFTWARE OR FOR IF YOU REQUIRE A PROFESSIONAL ENGINEER'S SEAL, PLEASE CONTACT A & A SOFTWARE DEVELOPMENT AT 5911 RENAISSANCE PLACE, SUITE B, TOLEDO, OH 43623 OR AT 1-419-292-1983



1280 S. Buena Vista St, Suite A
 San Jacinto, CA 92583
 1-888-268-3777

OWNER:

RYAN RODRIGUEZ

LOCATION:

4245 SCIARONI RD.
 GRIZZLY FLATS, CA 95635

SHEET TITLE:

COVER SHEET

PROJECT NO.:

20I-12-0838

DRAWN BY:

CQ


DATE:

9/18/2012

SHEET NO.:

1 OF 7





SEAL

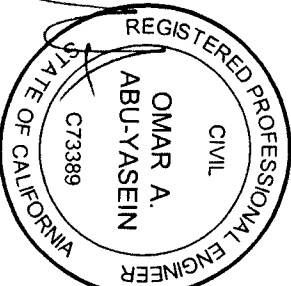

EXPIRES: 12/31/2012

DATE SIGNED: SEP 18 2012

10/25/0

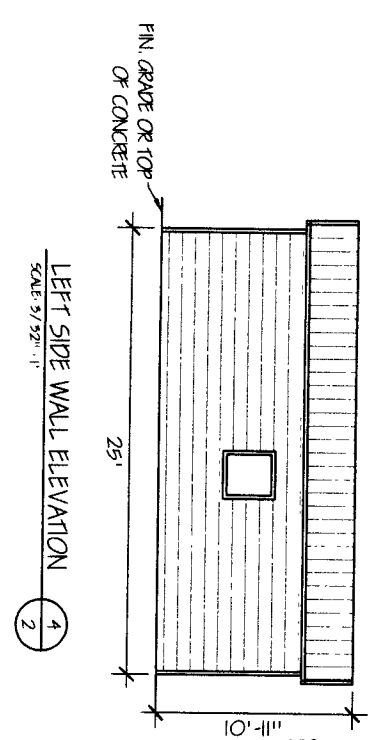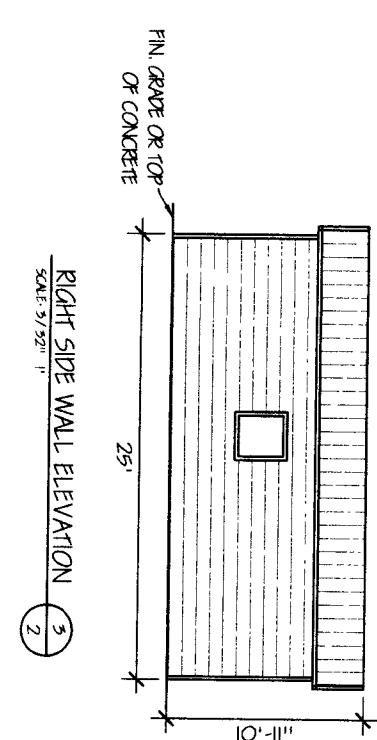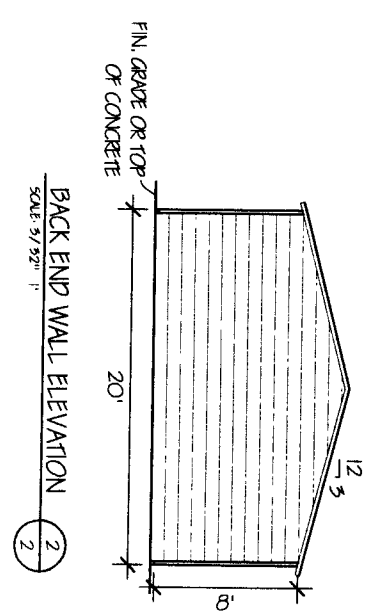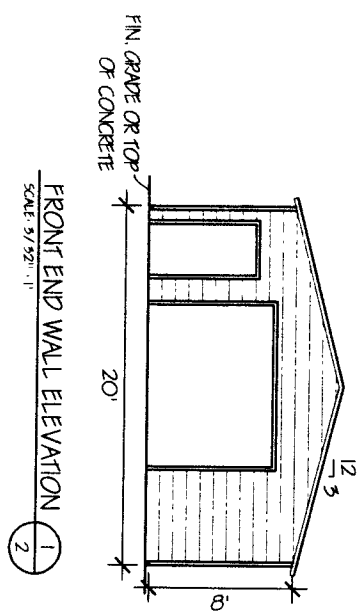

WINDOW LOCATION
AS PER CUSTOMER

DEC 05 2012


and Lays must be complied with
Permit # 211 664

APPROVED

Omissions & Errors on Plans
shall not be valid and all codes




1280 S. Buena Vista St, Suite A
San Jacinto, CA 92583
1-888-268-3777

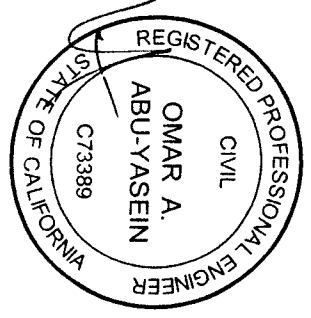

EXPIRES: 12/31/2012

DATE SIGNED: SEP 18 2012

OWNER: RYAN RODRIGUEZ	LOCATION: 4245 SCIARONI RD. GRIZZLY FLATS, CA 95635
SHEET TITLE: ELEVATIONS	
PROJECT NO.:	20I-12-0838
DRAWN BY:	CQ
DATE:	9/18/2012
SHEET NO.:	2 OF 7

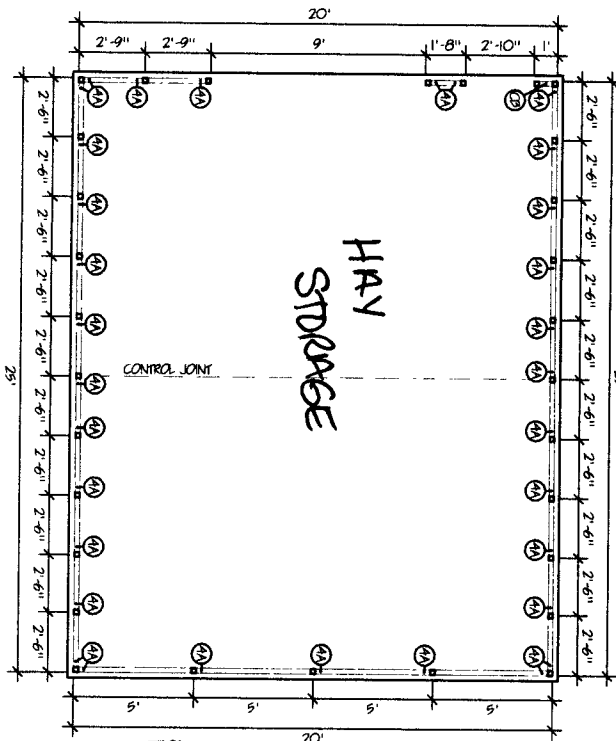


APPROVED
 Omissions & Errors on Plans
 shall not be valid and all codes
 DEC 05 2012

and Laws must be complied with
 map *SLC* Permit # **211664**

FLOOR PLAN 1
 SCALE 1/8" = 1'



ANCHOR LABEL LEGEND: (A) ANCHOR TYPE - SEE TABLE
 (B) DISTANCE IN INCHES FROM CENTER OF POST

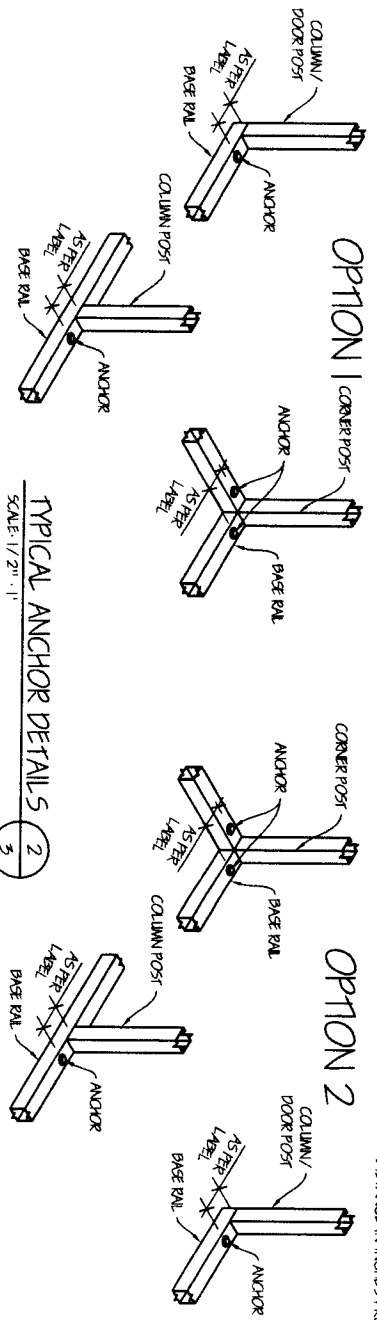

TYPICAL ANCHOR DETAILS 2
 SCALE: 1/2" = 1'

MEMBER PROPERTIES	
COLUMN POST	24" SQ. X 12GA TUBE
BASE RAIL	24" SQ. X 12GA TUBE
ANCHOR 'A'	CONCRETE SLAB
ANCHOR 'B'	3" Ø X 7" EXPANSION / WEDGE BOLTS

SEAL

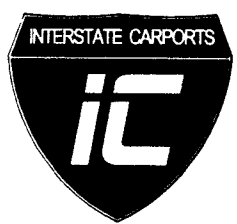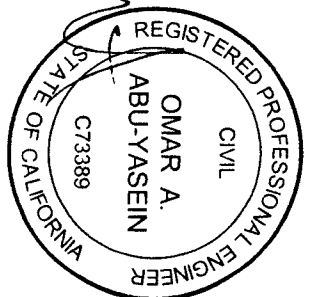

1280 S. Buena Vista St, Suite A
 San Jacinto, CA 92583
 1-888-268-3777

OWNER: RYAN RODRIGUEZ	LOCATION: 4245 SCIARONI RD. GRIZZLY FLATS, CA 95635
SHEET TITLE: FLOOR PLAN & ANCHORS	
PROJECT NO.:	201-12-0838
DRAWN BY:	CQ
DATE: 9/18/2012	SHEET NO.: 3 OF 7

DATE SIGNED: SEP 18 2012
 EXPIRES: 12/31/2012

[illegible]

PLOT PLAN	PRO BOW AND BRIZZLEY DATA CA
OWNER	PETER ROEBLER
	288 8TH AVENUE SCHEMONE NY 12150
	PARCEL NO 41-021-08
	SCALE 1"=20'
	LOT AREA 5 AC
	ZONING RESIDENTIAL
	DATE AUG 14 1994
	Page 5 of 5